


845 Third Avenue

Rudin

Floor 19
As Built Plan

2,960 Sq. Ft.
Partial Floor Available

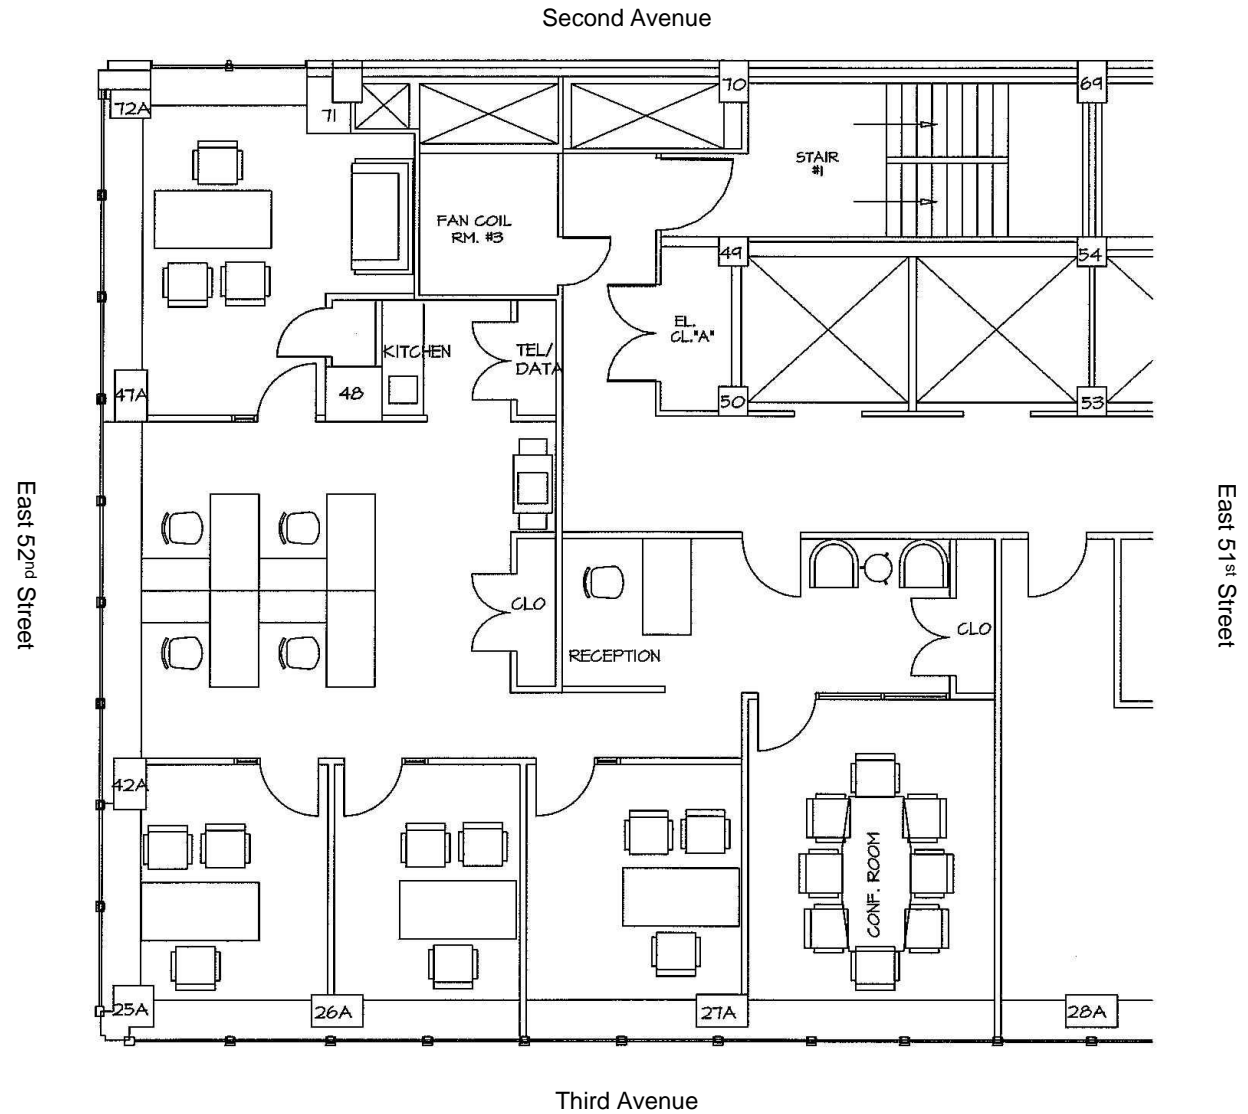

Robert Steinman

212.407.2490
rsteinman@rudin.com

rudin.com