


845 Third Avenue

Rudin

Floor 8
As Built Plan

11,136 Sq. Ft.
Partial Floor Available
June 2023

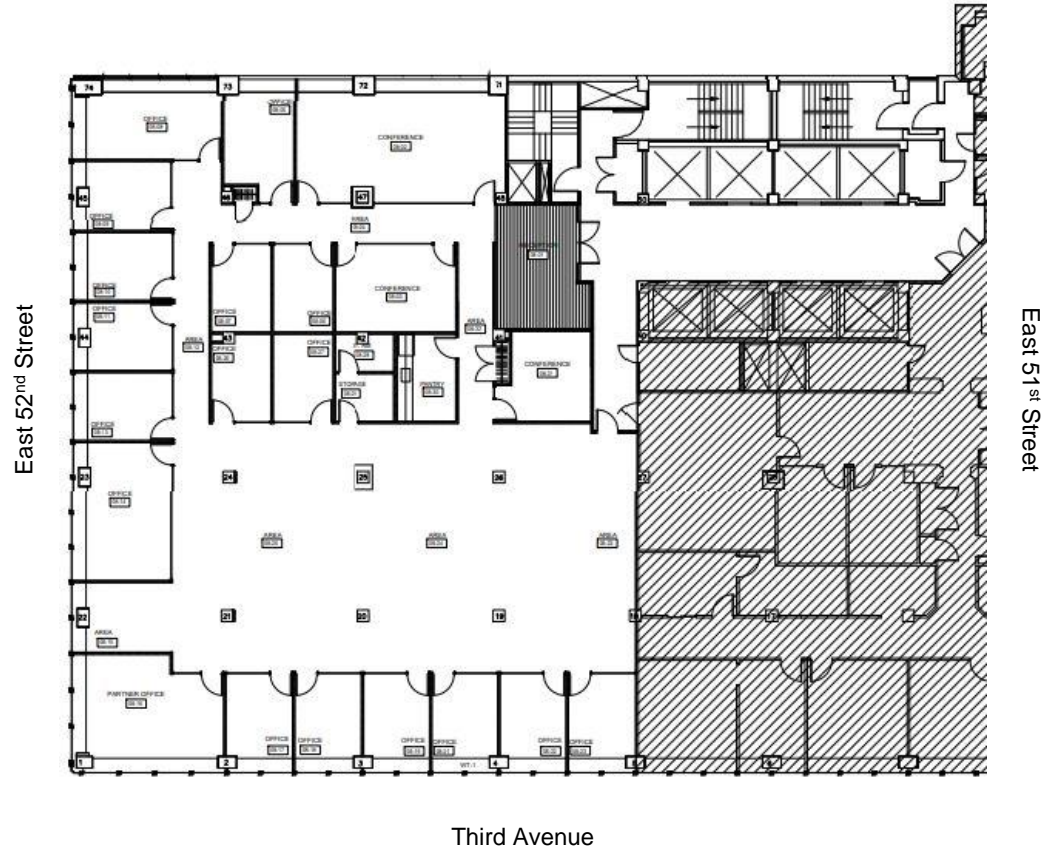

Robert Steinman

212.407.2490
rsteinman@rudin.com

rudin.com



REBNY