32 Avenue of the Americas

Rudin

13th Floor
As Built Floor Plan

52,518 Sq. Ft.
Full Floor Available
September 2020

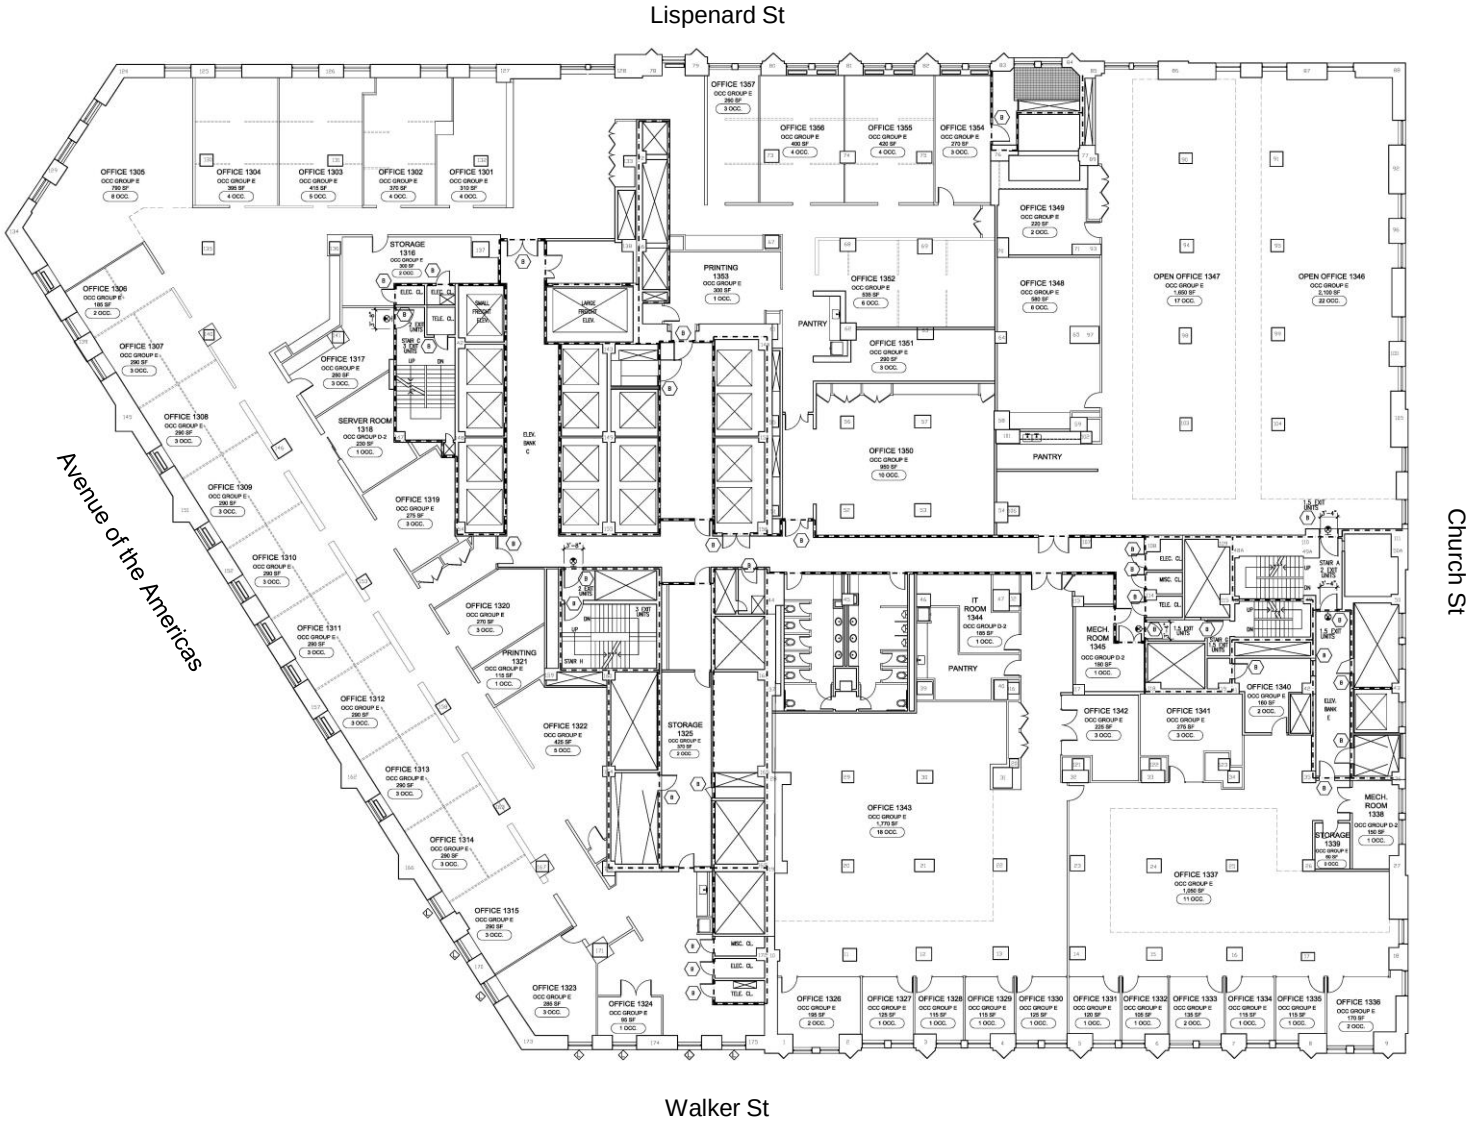

Robert Steinman

212.407.2490
rsteinman@rudin.com

rudin.com

REBNY